WATER TRANSMISSION IMPROVEMENTS

1980

COLLEGE MAIN

CITY OF BRYAN
ENGINEERING DEPARTMENT

CITY JOB NO. 611-CIP-801
PHASE III

[redacted]

D14007-1

612006

LOCATION MAP

Prop. 12" waterline

NORTH

COLLEGE MAIN
611-CIP-801
PHASE III

WATER TRANSMISSION
IMPROVEMENTS - 1983
COLLEGE MAIN

STATE OF TEXAS
JOHN D. PAGE, JR.
33679
REGISTERED PROFESSIONAL ENGINEER

ENGINEERING DEPARTMENT
CITY OF BRYAN

DESIGN D.R.F.	DATE 9-83
CHECKED J.O.P.	SCALE 1" = 600'
DRAWN D.R.F.	JOB NO. 611-CIP-801

D14007-2

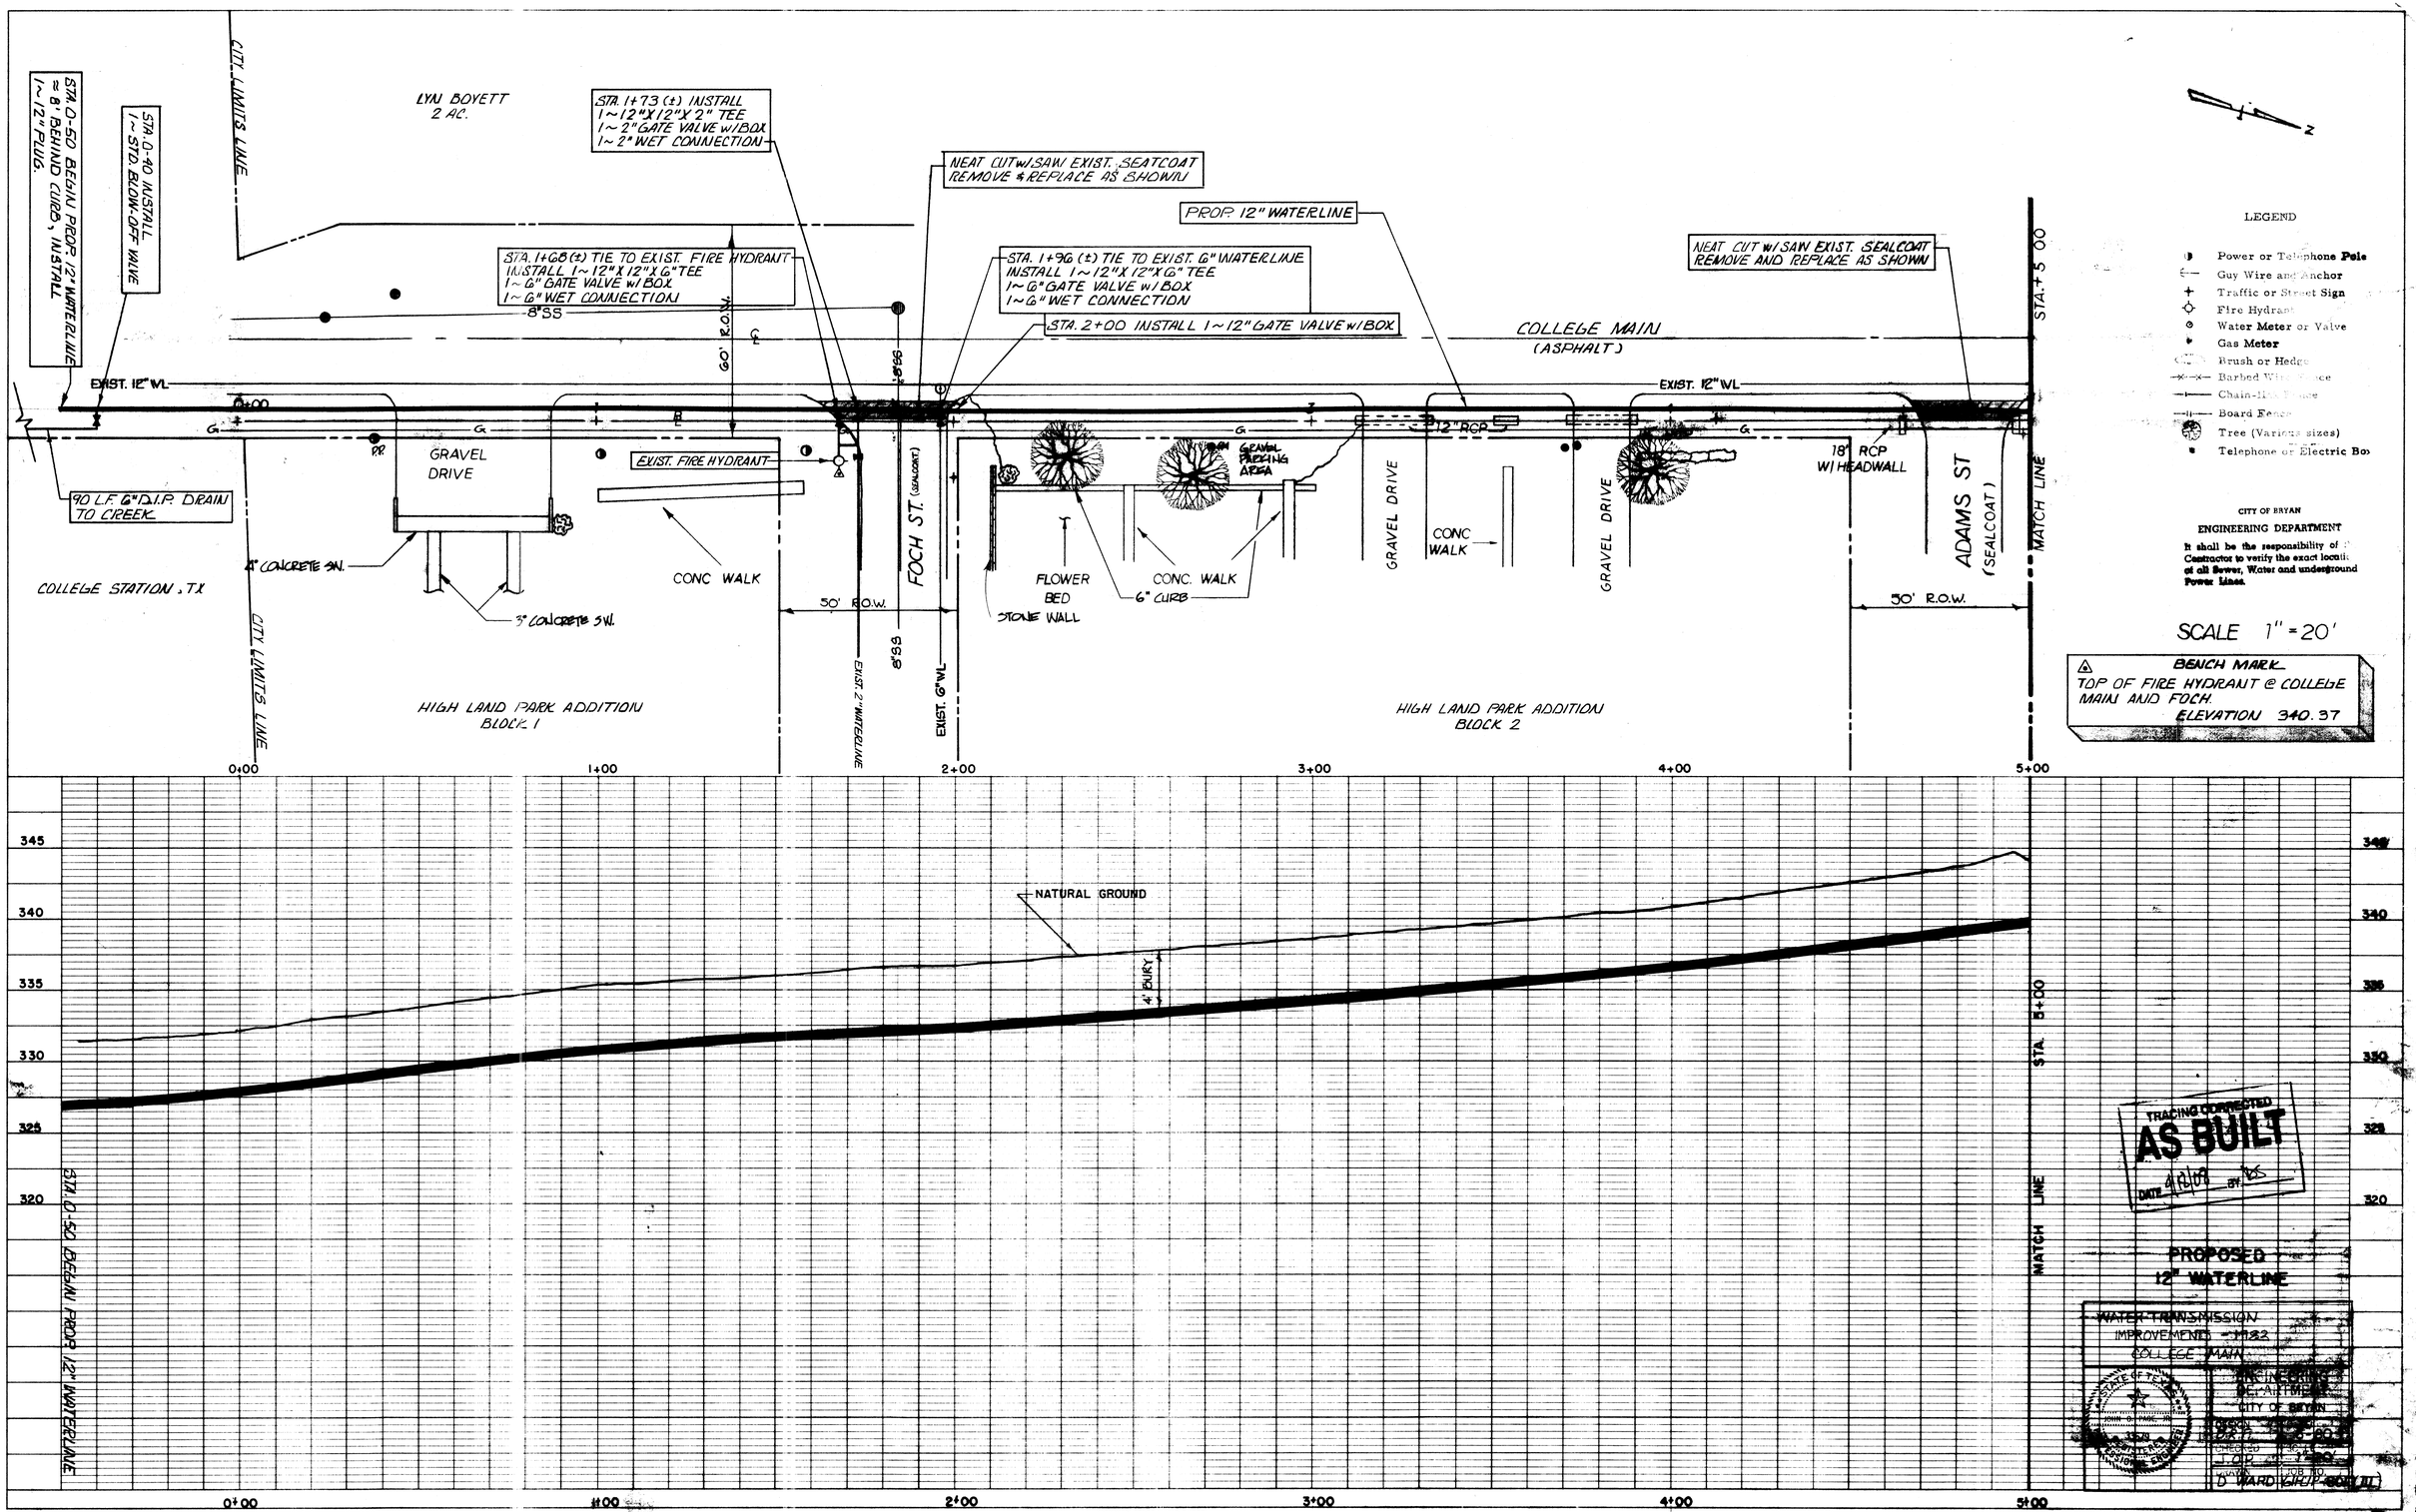

HIGHWAY FEDERAL AID SHEET
PLATE 1-SINGLE PLAN AND PROFILE-FULL LINE
TELEDYNE
PRINTED IN U.S.A.

D14007-3

9

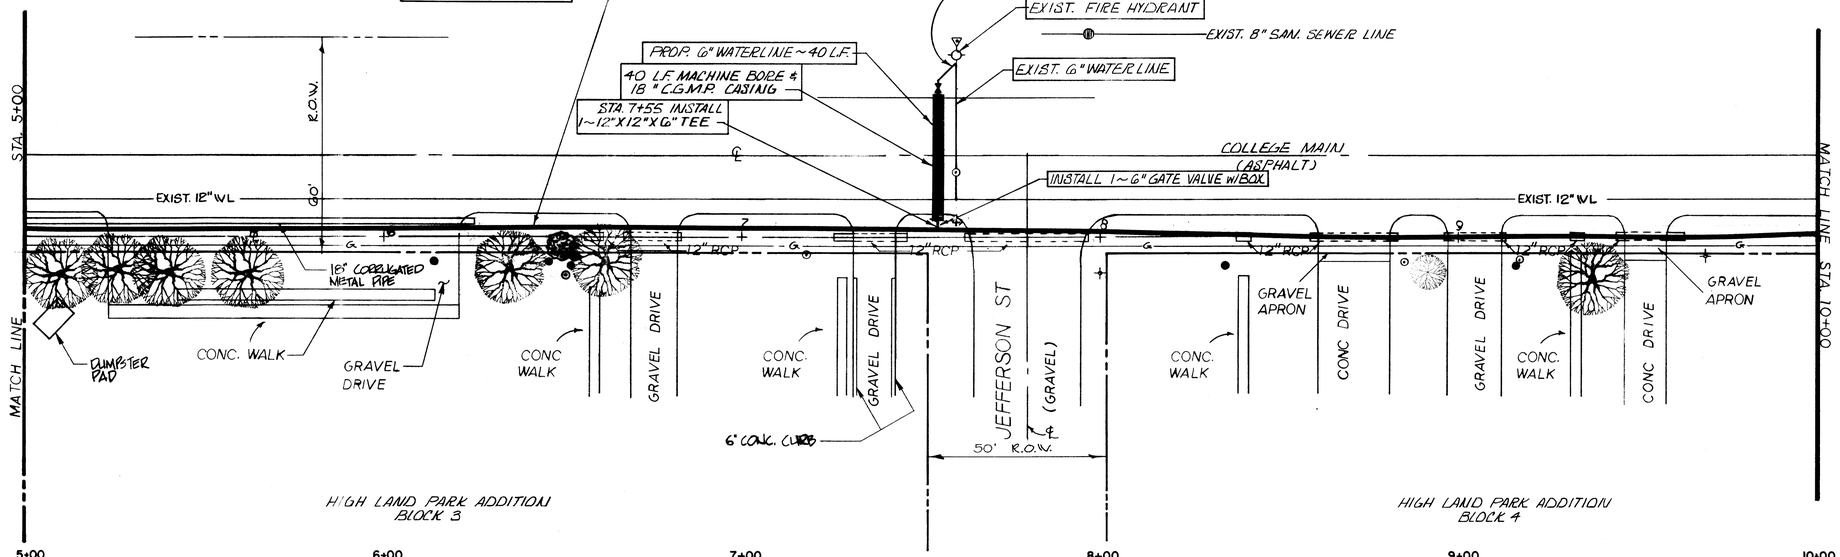

LEGEND

- Power or Telephone Pole
- Guy Wire and Anchor
- Traffic or Street Sign
- Fire Hydrant
- Water Meter or Valve
- Gas Meter
- Brush or Hedge
- Barbed Wire Fence
- Chain-link Fence
- Board Fence
- Tree (Various sizes)
- Telephone or Electric Box

SCALE 1" = 20'

CITY OF BRYAN
ENGINEERING DEPARTMENT
It shall be the responsibility of the Contractor to verify the exact location of all Sewer, Water and underground Power Lines.

BENCH MARK
TOP OF FIRE HYDRANT @ COLLEGE MAIN AND JEFFERSON STREET.
ELEVATION 354.07

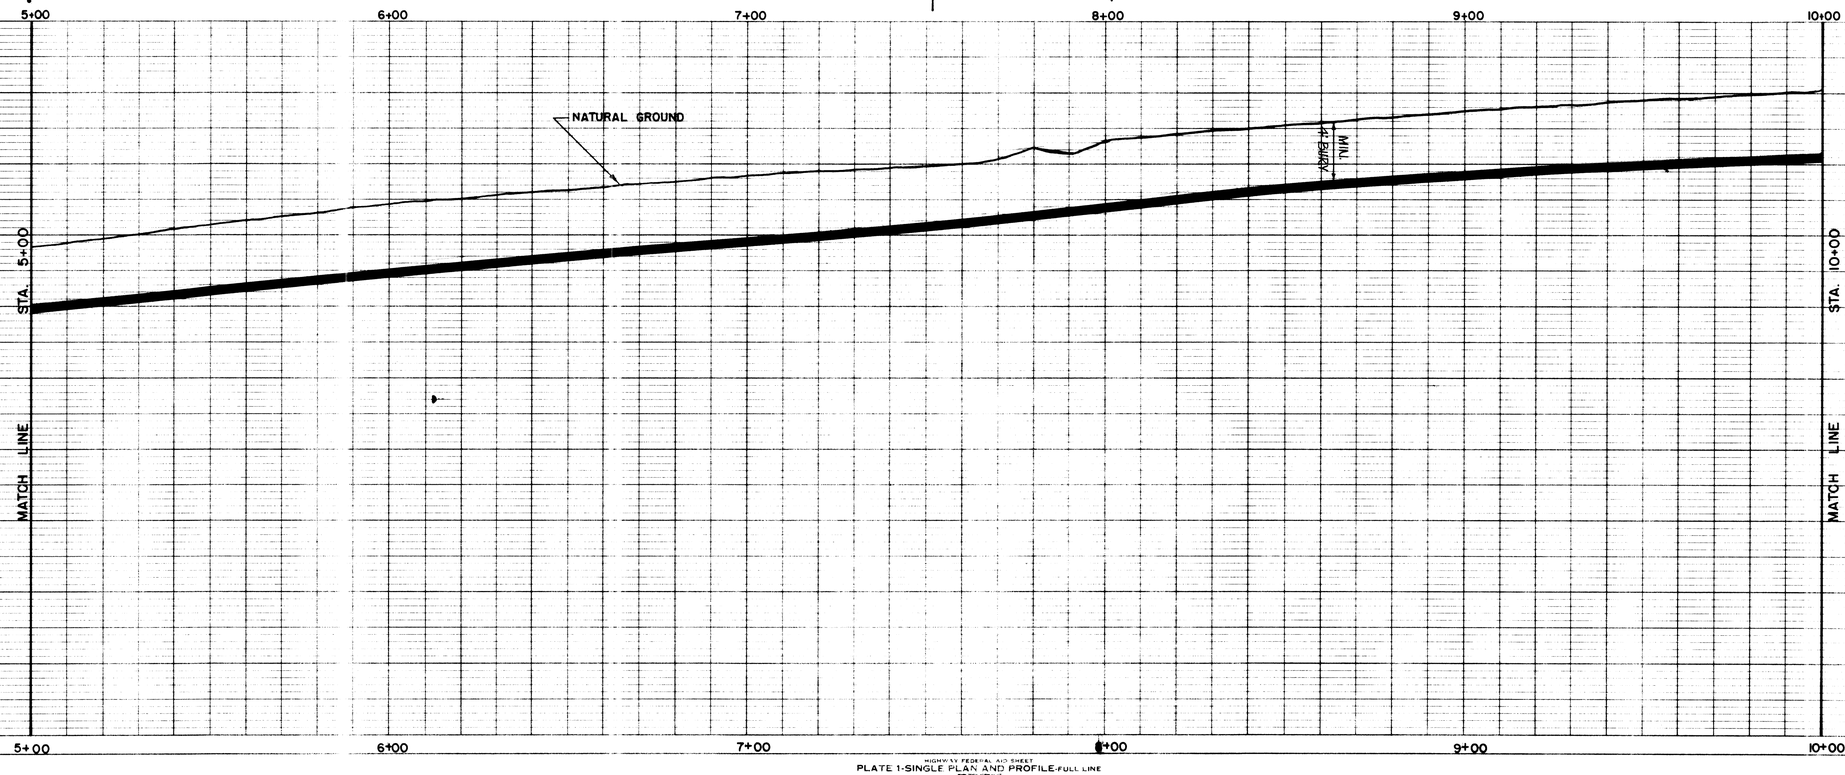

WORK CONTRACTED
AS BUILT
(18)08 05

PROPOSED
12" WATERLINE

WATER TRANSMISSION IMPROVEMENTS - 1983
COLLEGE MAIN

STATE OF TEXAS
JOHN D. FOSS JR.
33679
REGISTERED PROFESSIONAL ENGINEER

ENGINEERING DEPARTMENT
CITY OF BRYAN

DESIGN D.K.F.	DATE 6-80
CHECKED J.O.P.	SCALE 1"=20'
DRAWN D. WARD	JOB NO. 61-CIP-501 (III)

PLAN — SURVEYED / PLOTTED / NOTE BOOK / No. / ALIGNMENT CHECKED / R.O.W. CHECKED — BY / DATE

PROFILE — SURVEYED / PLOTTED / GRADES CHECKED / B.M.'s NOTED / STRUCTURE LOCATIONS CHECKED — BY / DATE

HIGHWAY FEDERAL AID SHEET
PLATE 1-SINGLE PLAN AND PROFILE-FULL LINE
TEXAS HIGHWAY DEPARTMENT
PRINTED IN U.S.A.

D14007-4 (4/9)

~~S-2000A-3~~

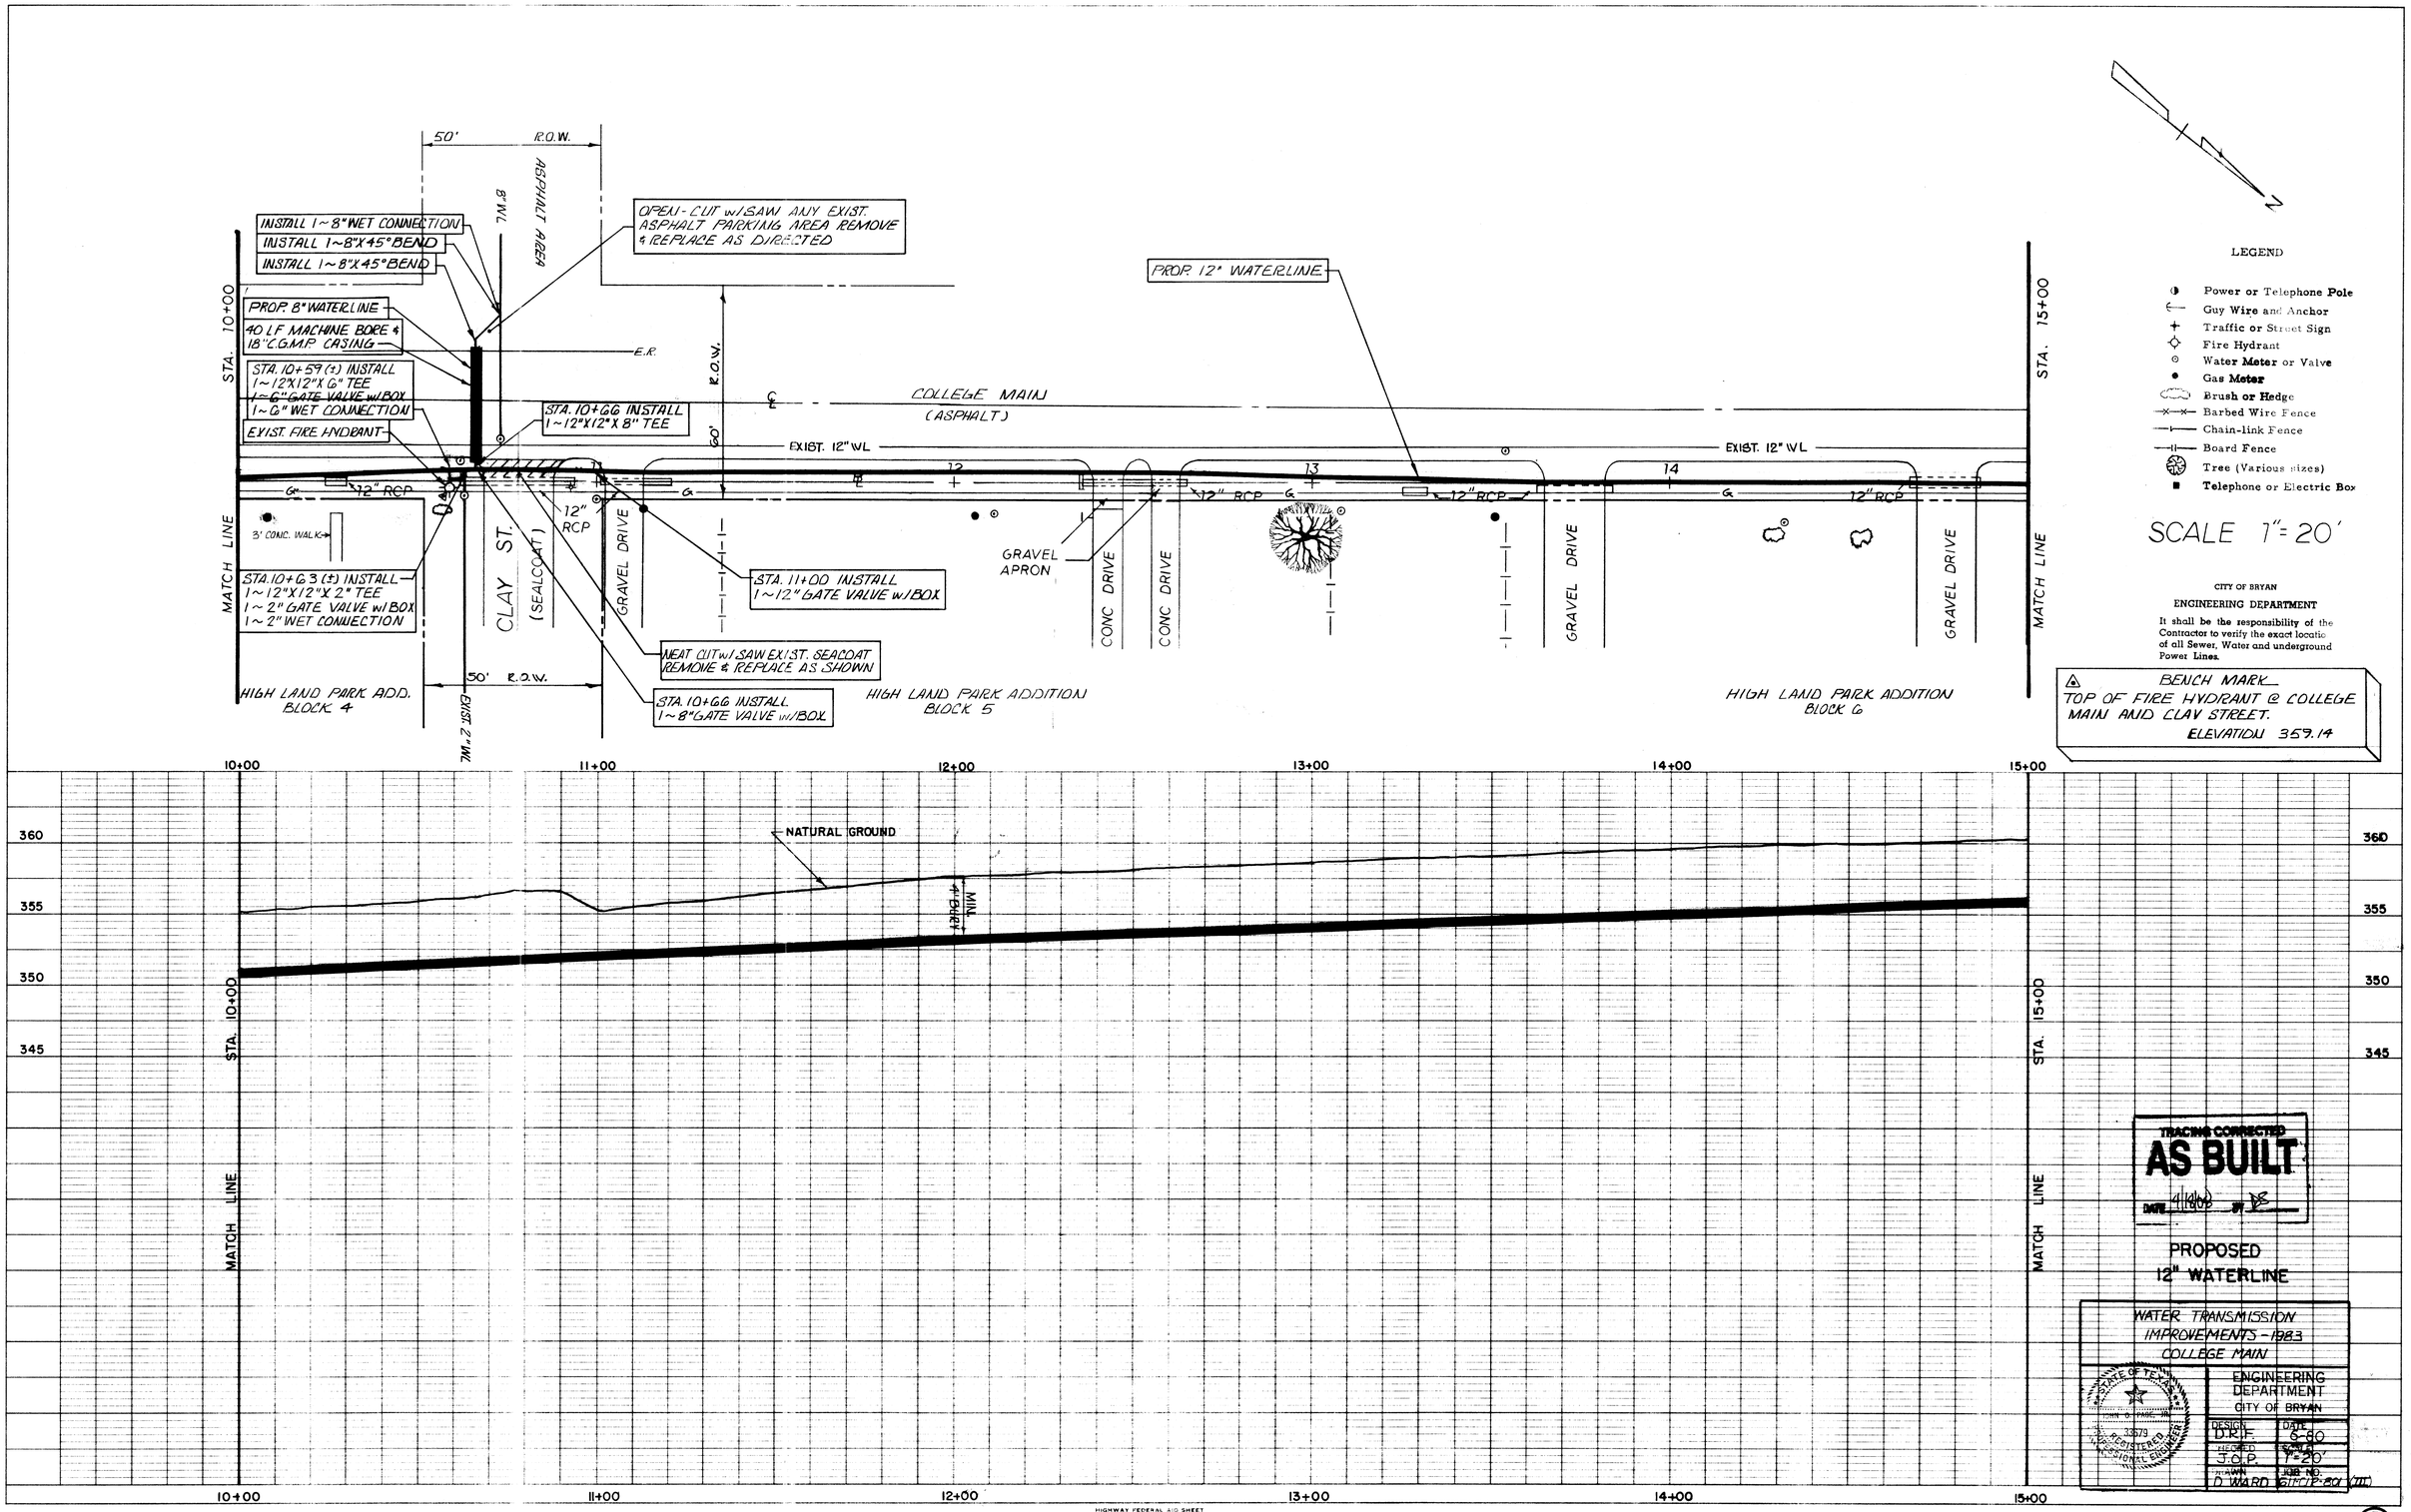

HIGHWAY FEDERAL AID SHEET
PLATE 1-SINGLE PLAN AND PROFILE-FULL LINE
TELEDYNE
PRINTED IN U.S.A.

D14007-5

5/9

~~012906A-4~~

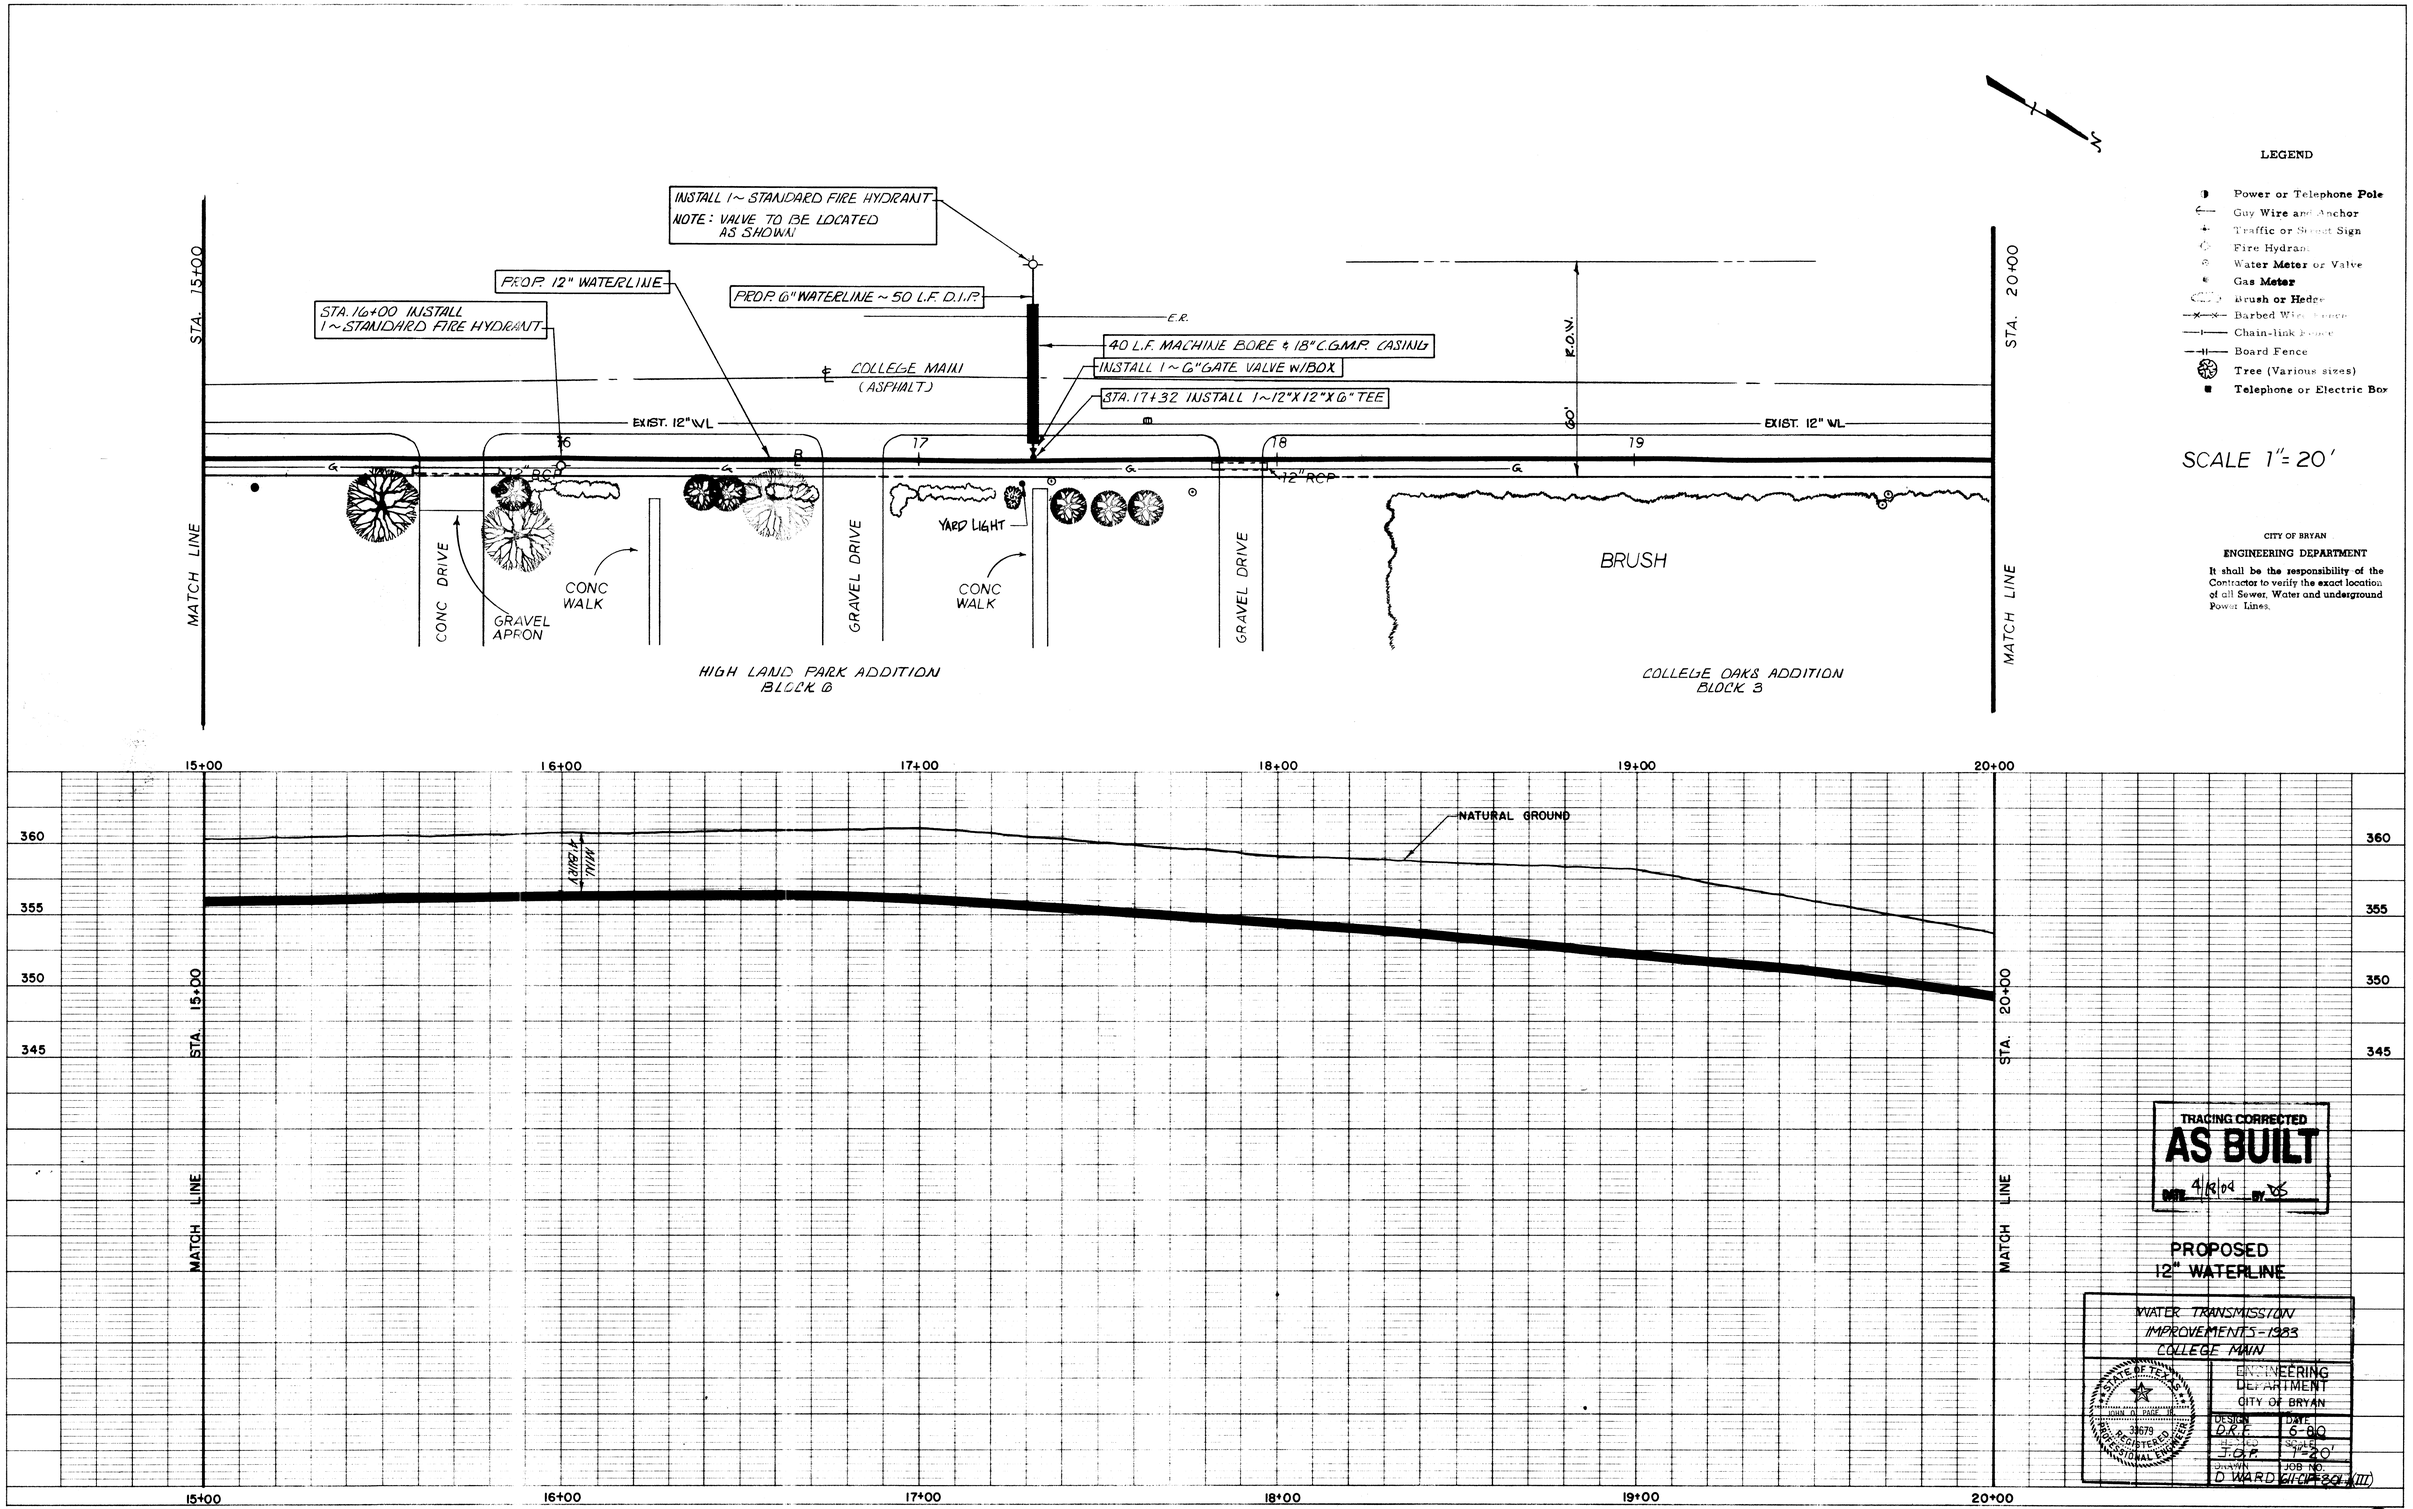

LEGEND

- Power or Telephone Pole
- Guy Wire and Anchor
- Traffic or Street Sign
- Fire Hydrant
- Water Meter or Valve
- Gas Meter
- Brush or Hedge
- Barbed Wire Fence
- Chain-link Fence
- Board Fence
- Tree (Various sizes)
- Telephone or Electric Box

SCALE 1" = 20'

CITY OF BRYAN
ENGINEERING DEPARTMENT

It shall be the responsibility of the Contractor to verify the exact location of all Sewer, Water and underground Power Lines.

TRACING CORRECTED
AS BUILT
DATE 4/18/04 BY DS

PROPOSED
12" WATERLINE

WATER TRANSMISSION IMPROVEMENTS-1983
COLLEGE MAIN

ENGINEERING DEPARTMENT
CITY OF BRYAN

DESIGN	DATE
D.R.F.	6-80
CHECKED	SCALE
J.O.P.	1"=20'
DRAWN	JOB NO.
D WARD	611-CIP-801-4(III)

STATE OF TEXAS
JOHN O. PAGE
33679
REGISTERED PROFESSIONAL ENGINEER

PLAN
NOTE BOOK No.
SURVEYED
PLOTTED
ALIGNMENT CHECKED
RT. OF WAY CHECKED

PROFILE
NOTE BOOK No.
SURVEYED
PLOTTED
GRADES CHECKED
B. M.'s NOTED
STRUCTURE NOTATIONS CHECKED

HIGHWAY FEDERAL AID SHEET
PLATE 1-SINGLE PLAN AND PROFILE-FULL LINE
PRINTED IN U.S.A.

D14007-6

6/9

~~012006A-5~~

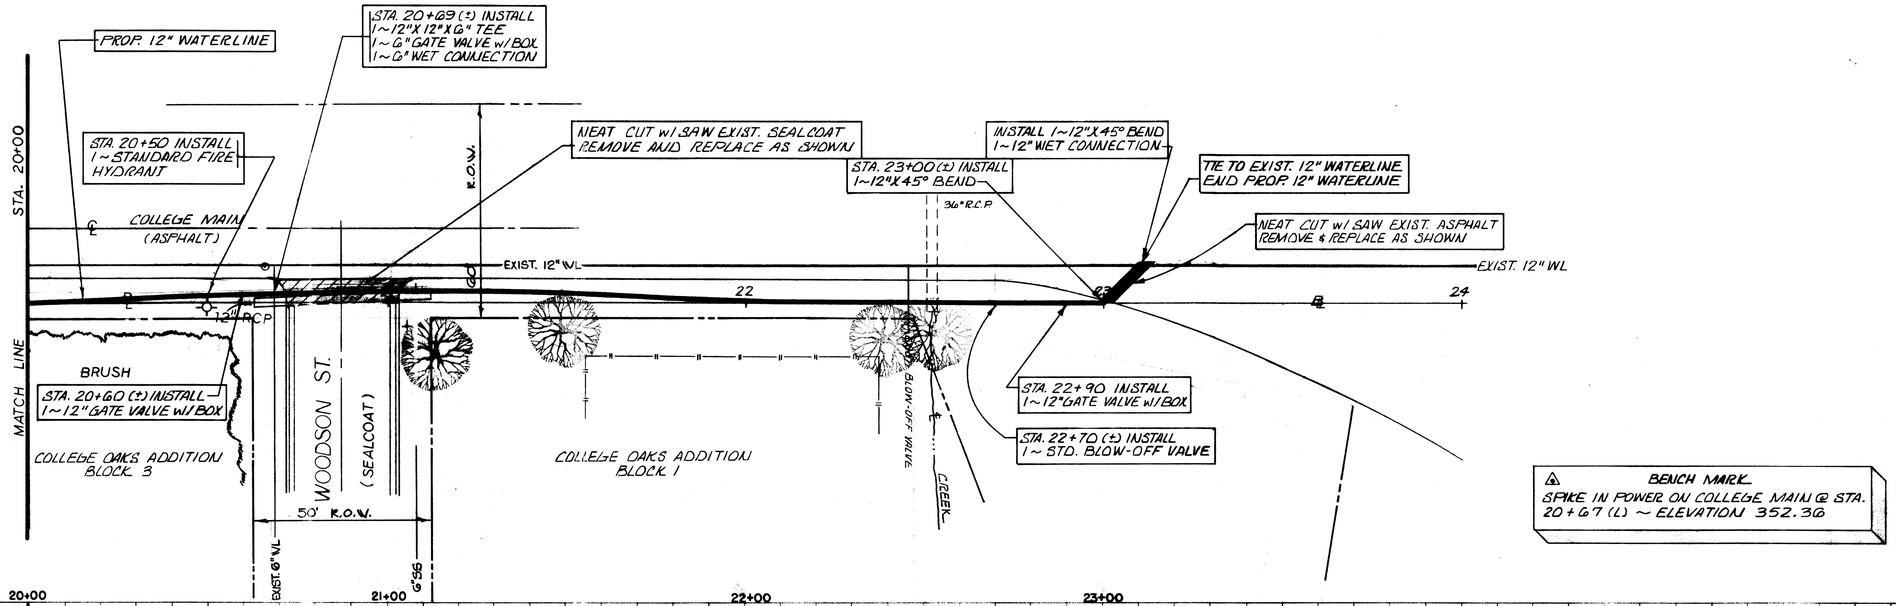

LEGEND

- Power or Telephone Pole
- Guy Wire and Anchor
- Traffic or Street Sign
- Fire Hydrant
- Water Meter or Valve
- Gas Meter
- Brush or Hedge
- Barbed Wire Fence
- Chain-link Fence
- Board Fence
- Tree (Various sizes)
- Telephone or Electric Box

SCALE 1"=20'

CITY OF BRYAN
ENGINEERING DEPARTMENT
It shall be the responsibility of the Contractor to verify the exact location of all Sewer, Water and underground Power Lines.

TRACING CORRECTED
AS BUILT
DATE 4/12/02 BY

PROPOSED
12" WATERLINE

WATER TRANSMISSION
IMPROVEMENTS - 1983
COLLEGE MAIN

ENGINEERING DEPARTMENT
CITY OF BRYAN

DESIGN	DATE
D.R.P.	6-80
DRAWN	JOB NO.
D. WARD	6-CM-20 (m)

PLAN: SURVEYED, PLOTTED, NOTE BOOK, ALIGNMENT CHECKED, BY OF WAT CHECKED, No.

PROFILE: SURVEYED, PLOTTED, NOTE BOOK, GRADES CHECKED, BY, STRUCTURE NOTATIONS CHECKED, No.

HIGHWAY FEDERAL AID SHEET
PLATE 1-SINGLE PLAN AND PROFILE-FULL LINE
1" = 20'
PRINTED IN U.S.A.

D14007-7 (7/9)

~~CTC 566A-6~~